



BRENTWOOD
BOROUGH COUNCIL

Local Plan 2015-2030

Preferred Options

July 2013

COMMENT FORM

(For official use only)

Comment
No.

Ack. date

You can comment on the Local Plan 2015-2030 Preferred Options online at www.brentwood.gov.uk/localplan. Alternatively, please use this form to share your views on the contents of the Local Plan.

PERSONAL DETAILS

Please indicate which section(s) of the Local Plan you are commenting on (please clearly state the Policy reference or paragraph number):

Policy CP7: BRENTWOOD ENTERPRISE PARK

Please specify if you Support or Object (tick as appropriate):

Support

☐

Object

☐

Comments (please use additional sheet if required):


I am concerned about the possible future use of the area to the S/E of the former M25 works site (marked x on enclosed map, and the possibility that this land might at some future date, after the completion of the present proposed development, be incorporated into the development site. There has already been precedent for this at Coddhops)

I am also concerned regarding the future end status (of public footpath or permissive) of the footpath which originally crossed the M25 Works site (marked —) and was subsequently diverted around the site (marked ---). In addition the ~~Public~~ Bridle path which runs along ~~the~~ ^{Northern} boundary, parallel to the A127.

Please return to Planning Policy Team, Brentwood Borough Council, Town Hall, Brentwood, Essex CM15 8AY, or alternatively attach completed form and email planning.policy@brentwood.gov.uk

Please note that all responses will be published online. More information can be found at www.brentwood.gov.uk/localplan

All responses should be received by Wednesday 2nd October 2013

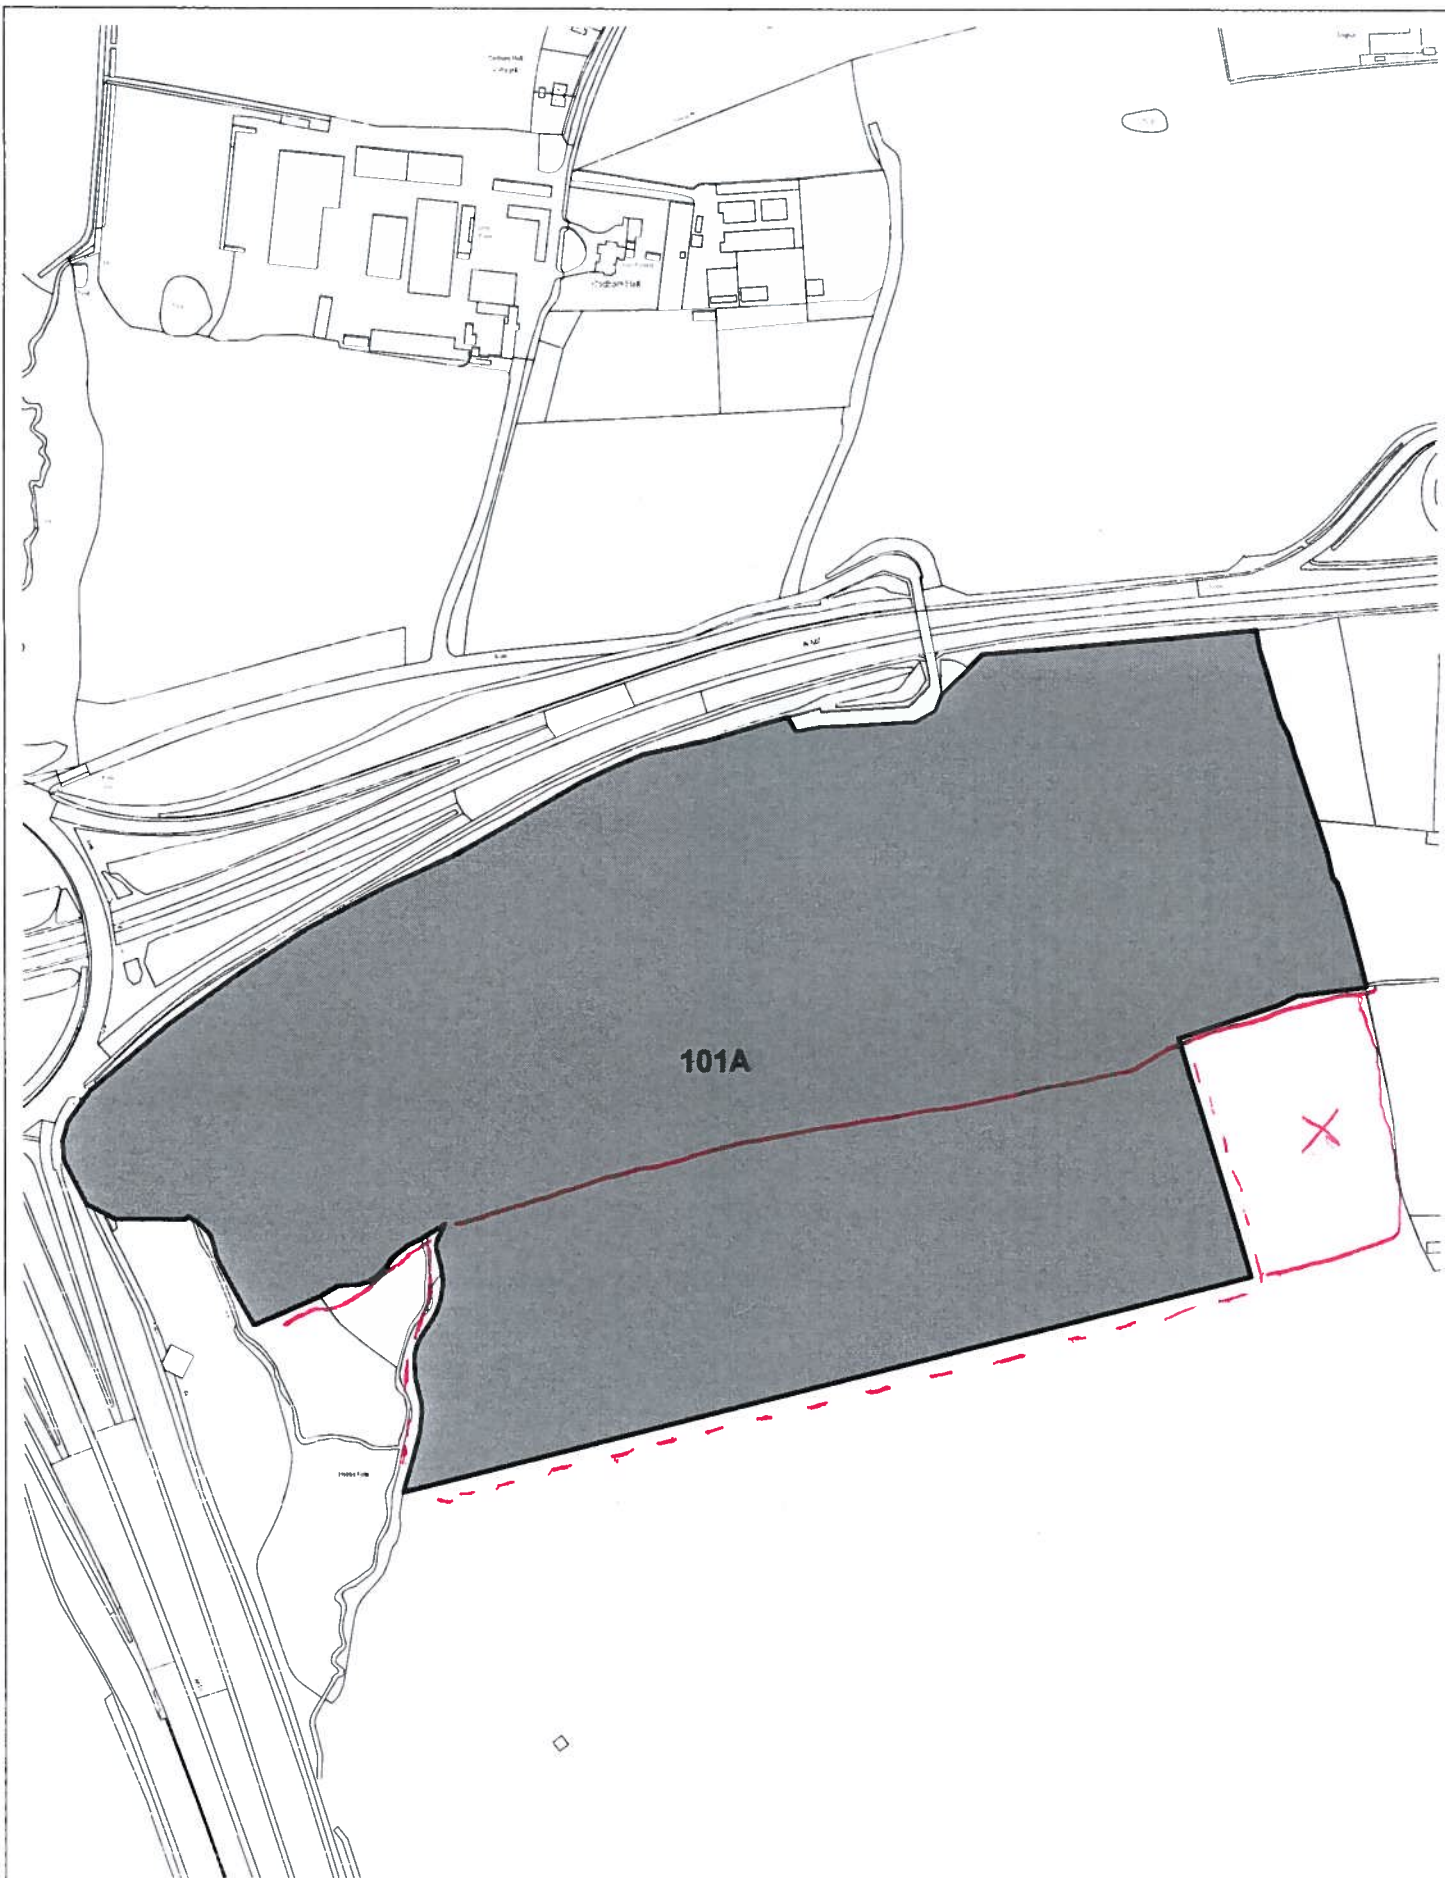

Title Land at former M25 Works Site, South of A127
Scale 1:4500
Date 8th July 2013

© Crown copyright and database rights 2012 Ordnance Survey 100018309